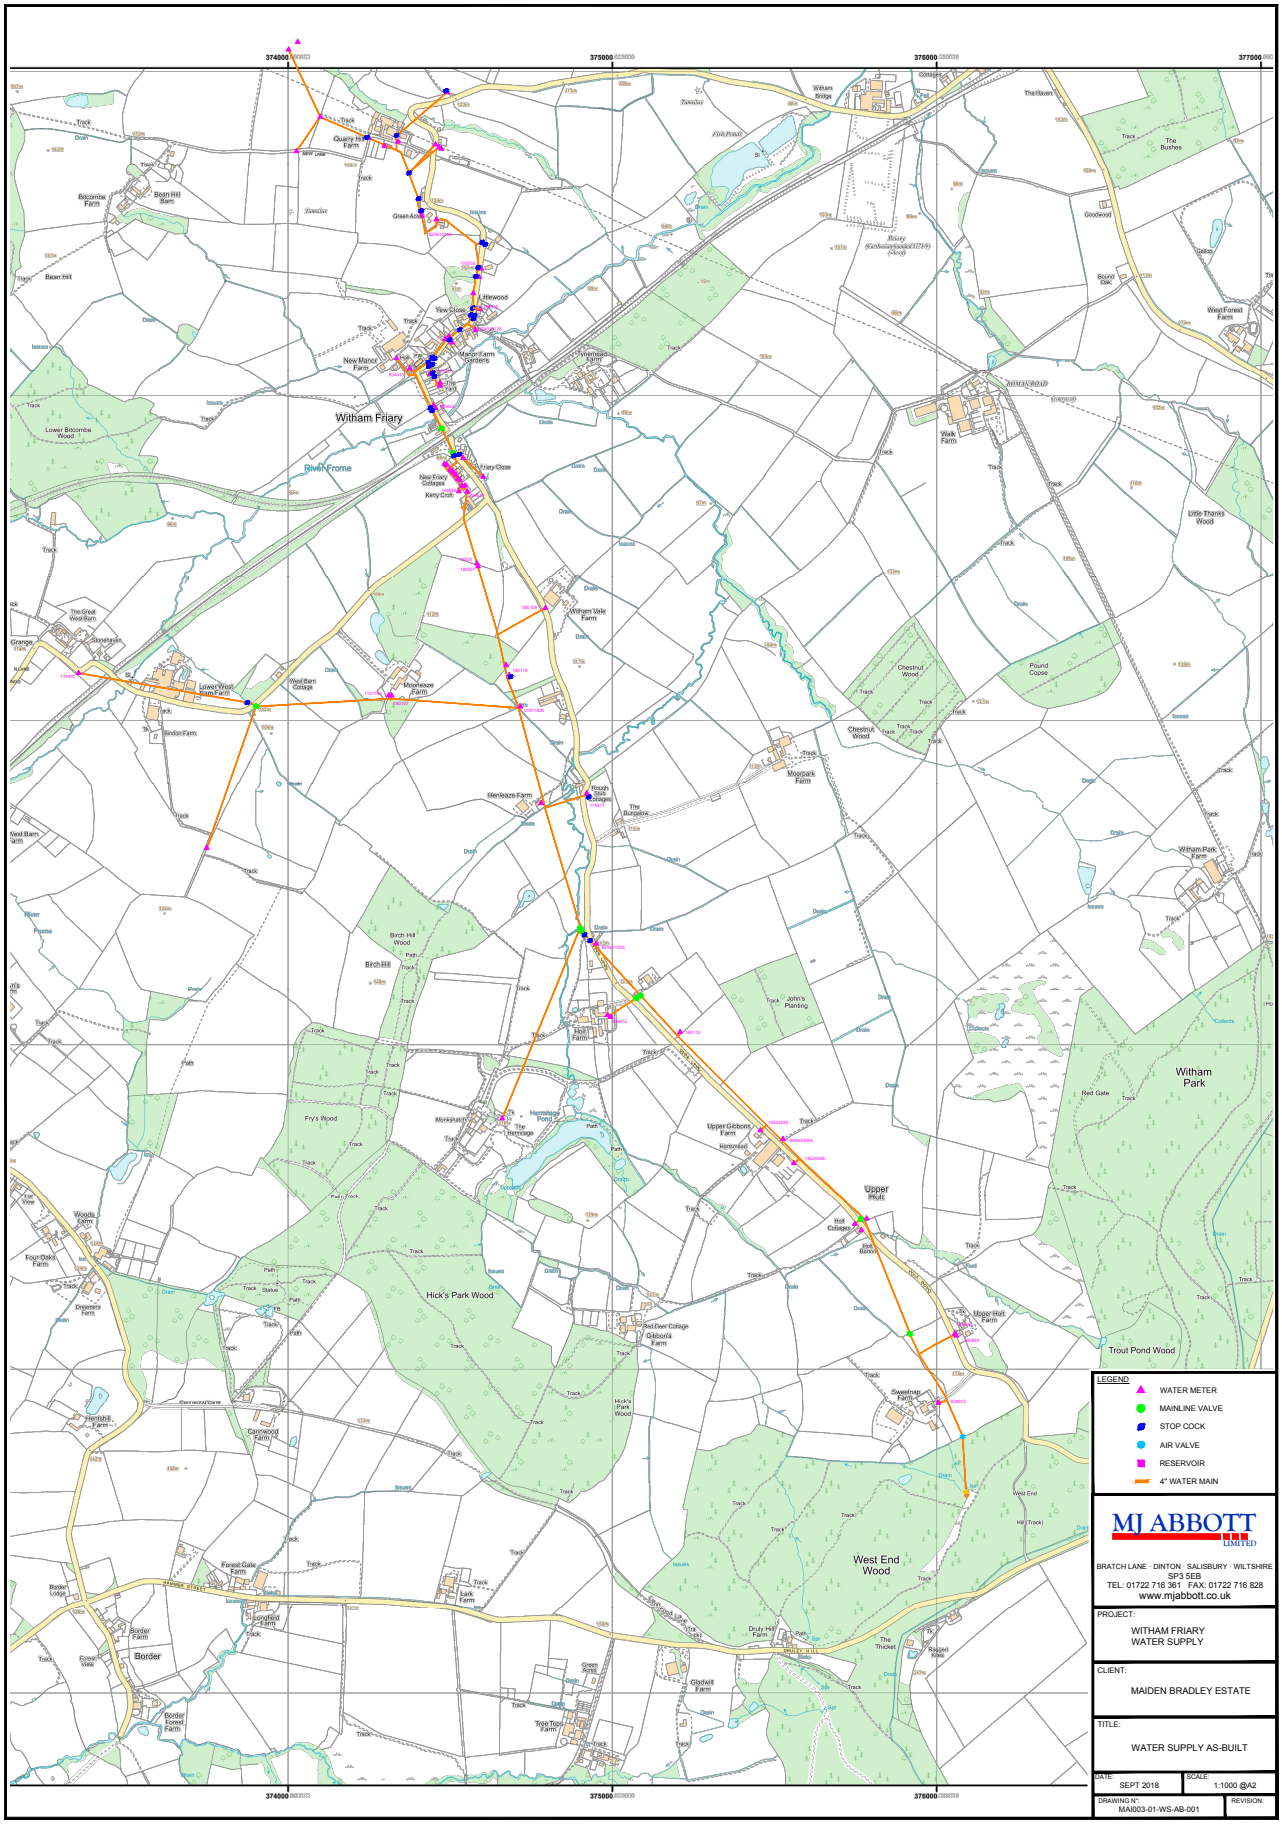

374000
375000
376000
377000
Witham Friary
River Frome
Witham Park
Hick's Park Wood
West End Wood
Trout Pond Wood
Upper Hurt
Border
LEGEND
WATER METER
MAINLINE VALVE
STOP COCK
AIR VALVE
RESERVOIR
4" WATER MAIN
MJ ABBOTT LIMITED
BRATCH LANE · DINTON · SALISBURY · WILTSHIRE SP3 5EB
TEL: 01722 716 361 FAX: 01722 716 828
www.mjabbott.co.uk
PROJECT:
WITHAM FRIARY WATER SUPPLY
CLIENT:
MAIDEN BRADLEY ESTATE
TITLE:
WATER SUPPLY AS-BUILT
DATE:
SEPT 2018
SCALE:
1:1000 @A2
DRAWING N°:
MAI003-01-WS-AB-001
REVISION: